

District 6, 7  
Certcode 1204-0

**CERTIFICATE OF HIGHWAY MILEAGE  
YEAR ENDING FEBRUARY 10, 2023**

Fill out form, make and file a copy with the Town Clerk, and submit the Mileage Certificate on or before February 20, 2023 to: Vermont Agency of Transportation, Division of Policy, Planning and Intermodal Development, Mapping Section via email to: aot.mileagecertificates@vermont.gov or if necessary via mail to: VTrans PPAID - Mapping Section, 219 North Main Street, Barre VT 05641.

We, the members of the legislative body of CABOT in WASHINGTON County on an oath state that the mileage of highways, according to Vermont Statutes Annotated, Title 19, Section 305, added 1985, is as follows:

**PART I - CHANGES TOTALS - Please fill in and calculate totals.**

Town Highways	Previous Mileage	Added Mileage	Subtracted Mileage	Total	Scenic Highways
Class 1	0.000			0.00	0.000
Class 2	17.030		<del>0.012</del>	<del>17.018</del> 17.030	0.000
Class 3	40.88			40.88	0.000
State Highway	6.568		0.012	<del>6.568</del> 6.556	0.000
<b>Total</b>	<b>64.478</b>			<b>64.466</b>	<b>0.000</b>
* Class 1 Lane	0.000			0.00	
* Class 4	7.42			7.42	0.000
* Legal Trail	4.61	0.02		4.63	

\* Mileage for Class 1 Lane, Class 4, and Legal Trail classifications are NOT included in total.

DS  
PO

Mileage corrections made by P. DeAndrea VTrans 3/27/2023. See correspondence 3/27/2023

**PART II - INFORMATION AND DESCRIPTION OF CHANGES SHOWN ABOVE.**

1. NEW HIGHWAYS: Please attach Selectmen's "Certificate of Completion and Opening".

+0.02 mi LT-6 due to US-2 realignment and bridge B88 relocation project #78d347

2. DISCONTINUED: Please attach SIGNED copy of proceedings (minutes of meeting).

3. RECLASSIFIED/REMEASURED: Please attach SIGNED copy of proceedings (minutes of meeting).

-0.012 mi US-2 realignment due to bridge B88 relocation project # 78d347

4. SCENIC HIGHWAYS: Please attach a copy of order designating/discontinuing Scenic Highways.

IF THERE ARE NO CHANGES IN MILEAGE: Place an X in the box and sign below.

**PART III - SIGNATURES - PLEASE SIGN.**

Signatures of Selectmen/ Aldermen/ Trustees:

*[Handwritten signatures: Michael Johnson, Walter Botticelli Jr]*

Signature of T/C/V Clerk: *Betty Ritter*

Date Filed: 3/21/23


Please sign ORIGINAL and return it for Transportation signature.

AGENCY OF TRANSPORTATION APPROVAL: Signed copy will be returned to T/C/V Clerk.

APPROVED:

*[Signature]*  
Johnathan Croft  
8B1E360F309C4C9  
Representative, Agency of Transportation

DATE: 4/28/2023

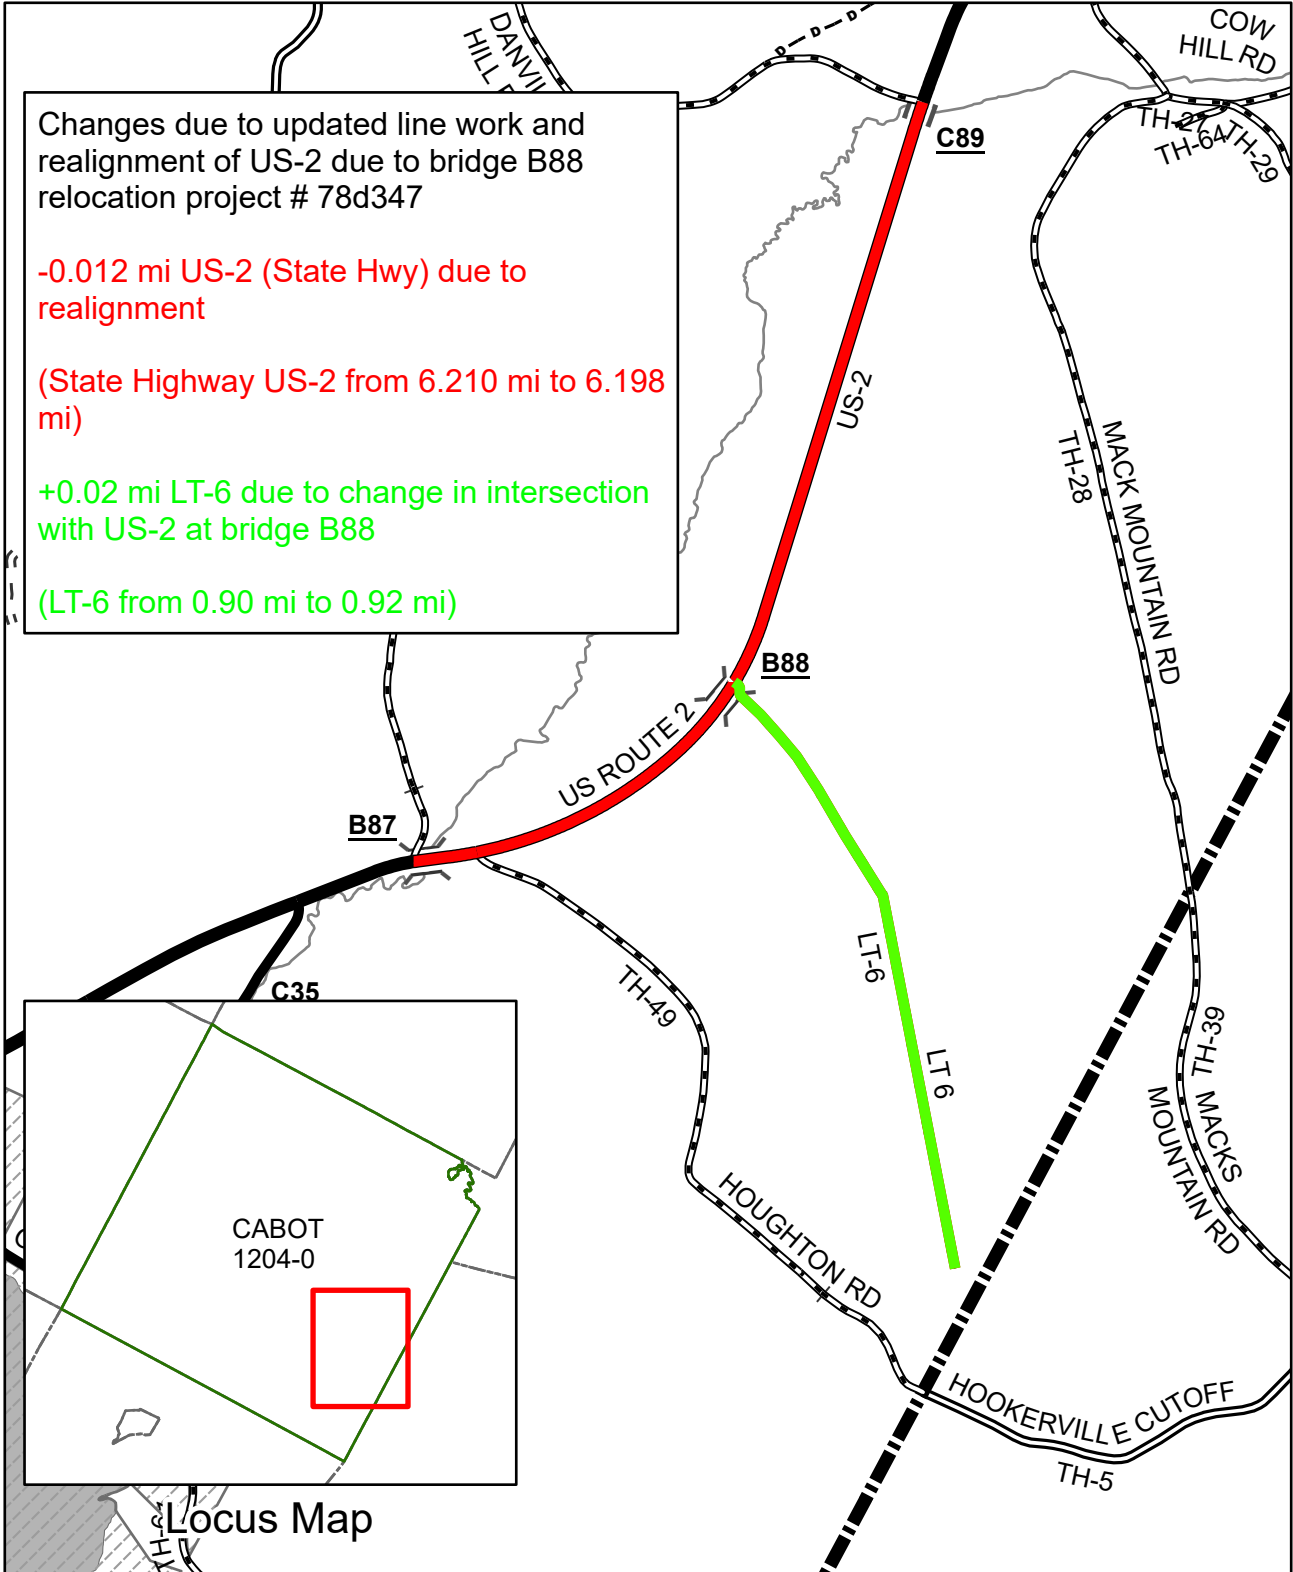



### Mileage Certificate Changes

#### CABOT

(CTUA:1204-0)  
(CERTCODE:1204-0)

Mapping Section  
Division of Policy and Planning  
Vermont Agency of Transportation -- December 28, 2022

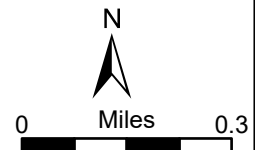

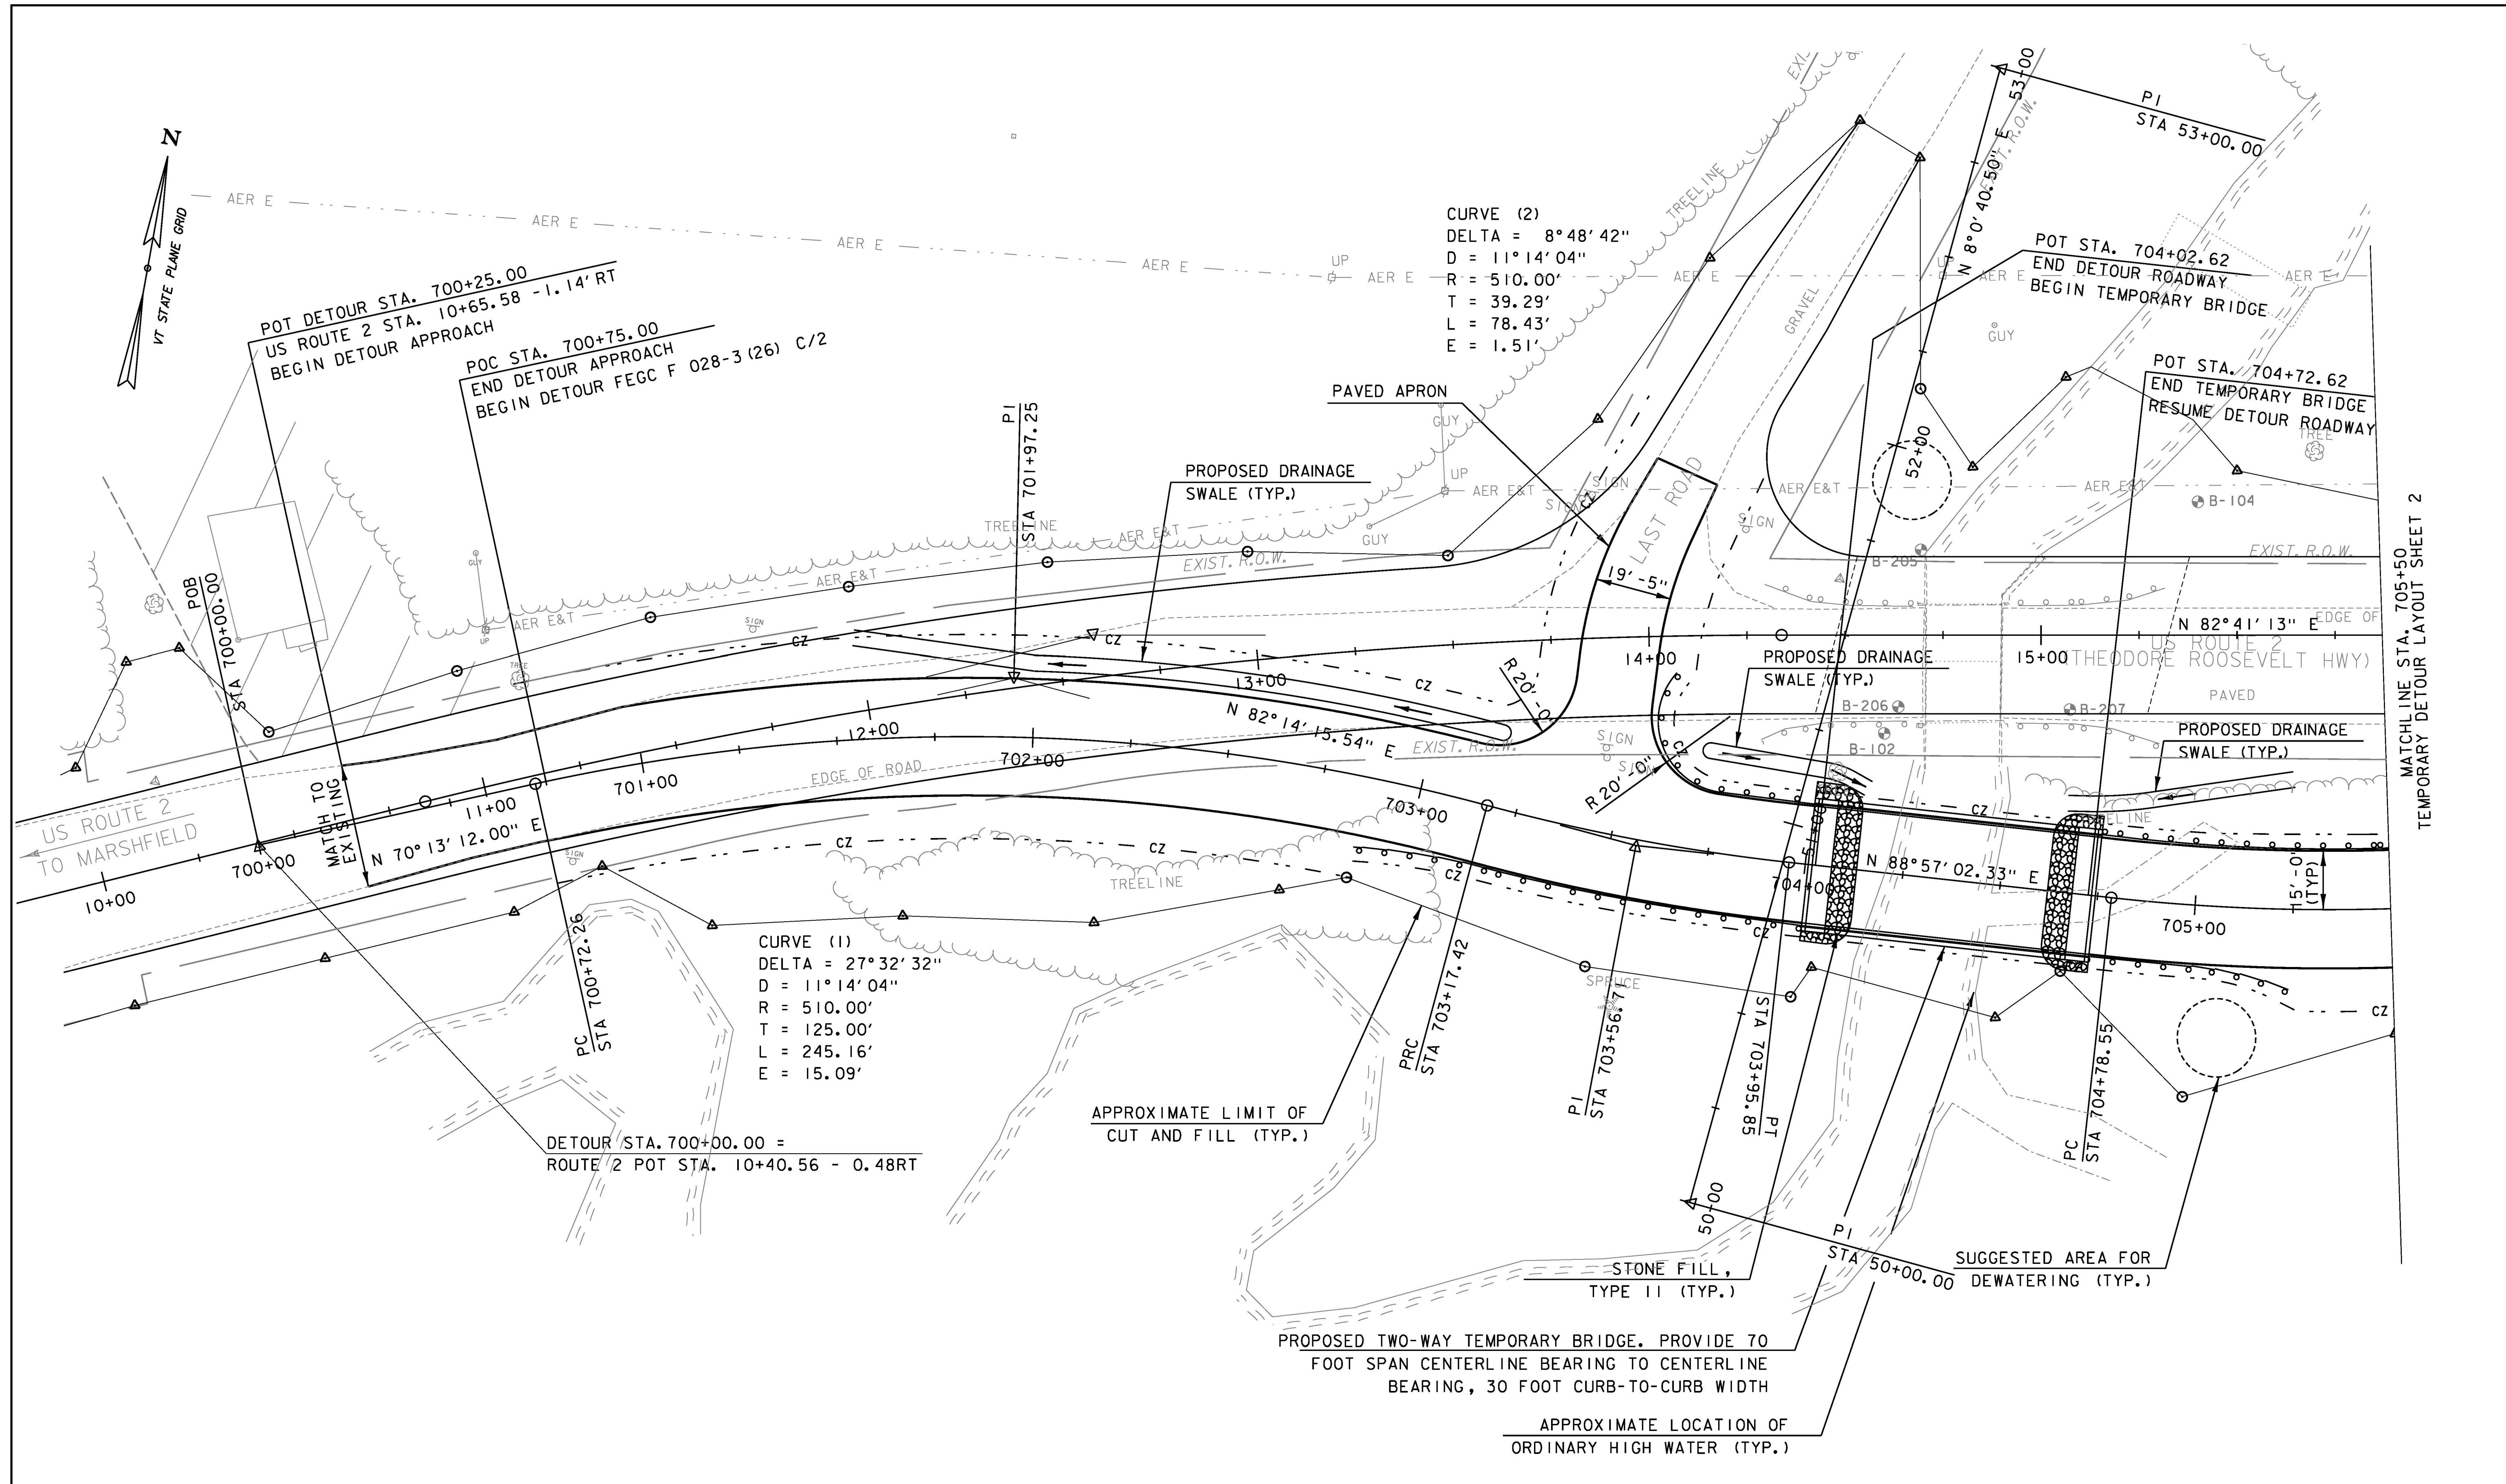

MATCHLINE STA. 705+50  
TEMPORARY DETOUR LAYOUT SHEET 2

CURVE (2)  
 DELTA = 8° 48' 42"  
 D = 11° 14' 04"  
 R = 510.00'  
 T = 39.29'  
 L = 78.43'  
 E = 1.51'

CURVE (1)  
 DELTA = 27° 32' 32"  
 D = 11° 14' 04"  
 R = 510.00'  
 T = 125.00'  
 L = 245.16'  
 E = 15.09'


DETOUR STA. 700+00.00 =  
 ROUTE 2 POT STA. 10+40.56 - 0.48RT

APPROXIMATE LIMIT OF  
 CUT AND FILL (TYP.)

PROPOSED TWO-WAY TEMPORARY BRIDGE. PROVIDE 70  
 FOOT SPAN CENTERLINE BEARING TO CENTERLINE  
 BEARING, 30 FOOT CURB-TO-CURB WIDTH



APPROXIMATE LOCATION OF  
 ORDINARY HIGH WATER (TYP.)

**NOTES:**  
 1. REFER TO SHEET 123 FOR TEMPORARY SIGNAGE AND PAVEMENT MARKING REQUIREMENTS.

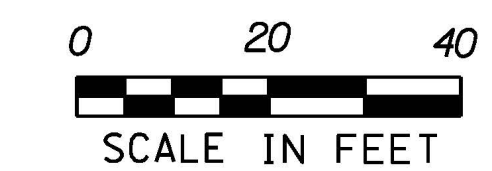

GREEN INTERNATIONAL AFFILIATES, INC.  
 CIVIL AND STRUCTURAL ENGINEERS

PROJECT NAME: CABOT - DANVILLE	
PROJECT NUMBER: FECC F 028-3(26) C/2	
FILE NAME: z78d347detbdr.dgn	PLOT DATE: 3/27/2017
PROJECT LEADER: M. CRUZ	DRAWN BY: D. VERTIYEV
DESIGNED BY: D. VERTIYEV	CHECKED BY: E. ATKINS
DETOUR LAYOUT SHEET 1 (BR 87)	SHEET 120 OF 273

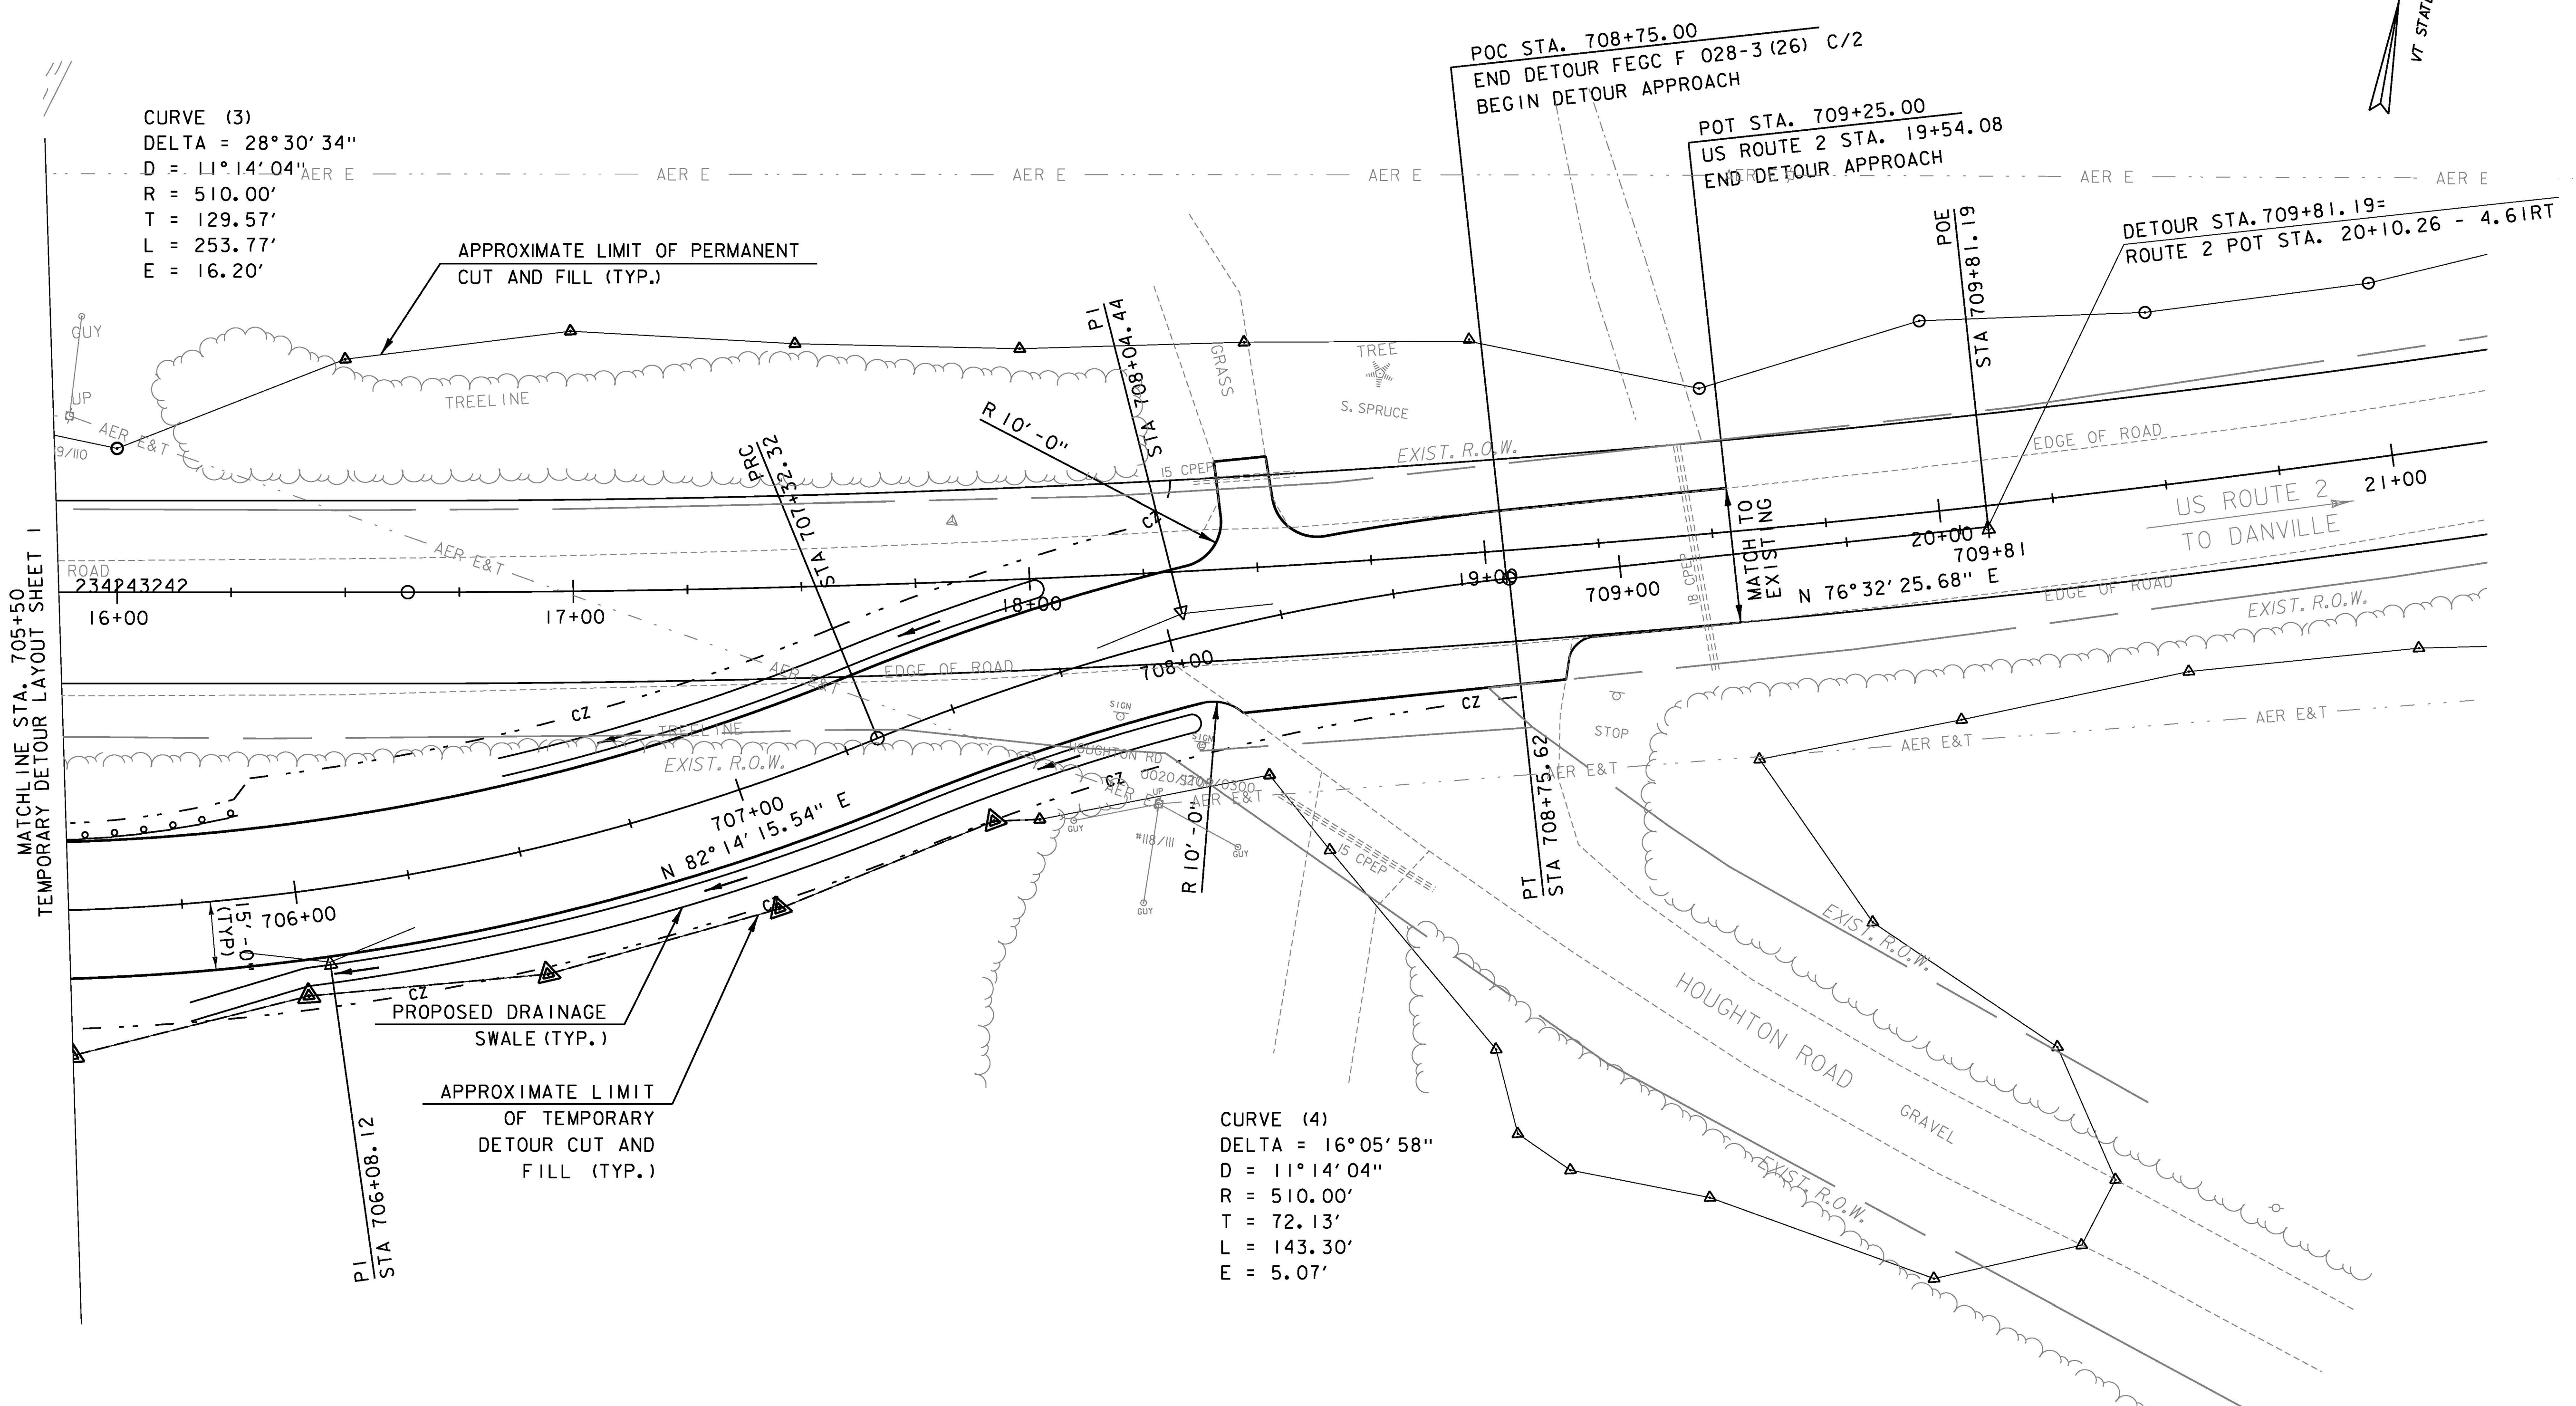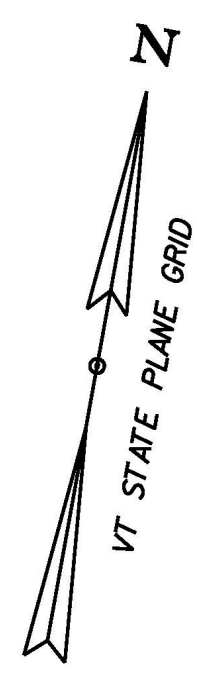

CURVE (3)  
 DELTA = 28° 30' 34"  
 D = 11° 14' 04"  
 R = 510.00'  
 T = 129.57'  
 L = 253.77'  
 E = 16.20'

CURVE (4)  
 DELTA = 16° 05' 58"  
 D = 11° 14' 04"  
 R = 510.00'  
 T = 72.13'  
 L = 143.30'  
 E = 5.07'

MATCHLINE STA. 705+50  
 TEMPORARY DETOUR LAYOUT SHEET 1

PROJECT NAME: CABOT - DANVILLE	
PROJECT NUMBER: FECC F 028-3(26) C/2	
FILE NAME: z78d347de+tdr.dgn	PLOT DATE: 3/27/2017
PROJECT LEADER: M. CRUZ	DRAWN BY: D. VERTIYEV
DESIGNED BY: D. VERTIYEV	CHECKED BY: E. ATKINS
DETOUR LAYOUT SHEET 2 (BR 87)	SHEET 121 OF 273



GREEN INTERNATIONAL AFFILIATES, INC.  
 CIVIL AND STRUCTURAL ENGINEERS

**NOTES:**  
 1. REFER TO SHEET 123 FOR TEMPORARY SIGNAGE AND PAVEMENT MARKING REQUIREMENTS.


**From:** [AOT - Mileage Certificates](#)  
**To:** [Michelle Leclerc](#); [AOT - Mileage Certificates](#); [tc@cabotvt.us](mailto:tc@cabotvt.us)  
**Cc:** [highway@cabotvt.us](mailto:highway@cabotvt.us)  
**Subject:** RE: 2023 Mileage Certificates attached  
**Date:** Friday, March 3, 2023 5:29:00 PM  
**Attachments:** [image001.png](#)  
[image002.png](#)  
[image003.png](#)  
[CABOT\\_MCert\\_2023\\_page1\\_Corrected.pdf](#)  
[1204\\_CABOT\\_US2\\_LT6.pdf](#)

---

Good afternoon Michelle,

I hope this email finds you well. I wanted to thank you for the 2023 Mileage Certificate. I do have some corrections and clarifications for you and the Selectboard. The questions/issues are as follows:

1. The certificate needs to be dated for the date when it was signed by the Town Clerk where it says "Date Filed".
2. The Town includes a reclassification for TH-34 from Class 3 to Class 4. We already have this listed as a Class 4 road as you can see in the following images (yellow highlights), which are excerpts from the current Cabot Town Highway Map completed in 2019. This classification dates back to the 70s. Did you intend to report a different road on the certificate? If not I will need to update the mileage in Part I of the attached certificate.

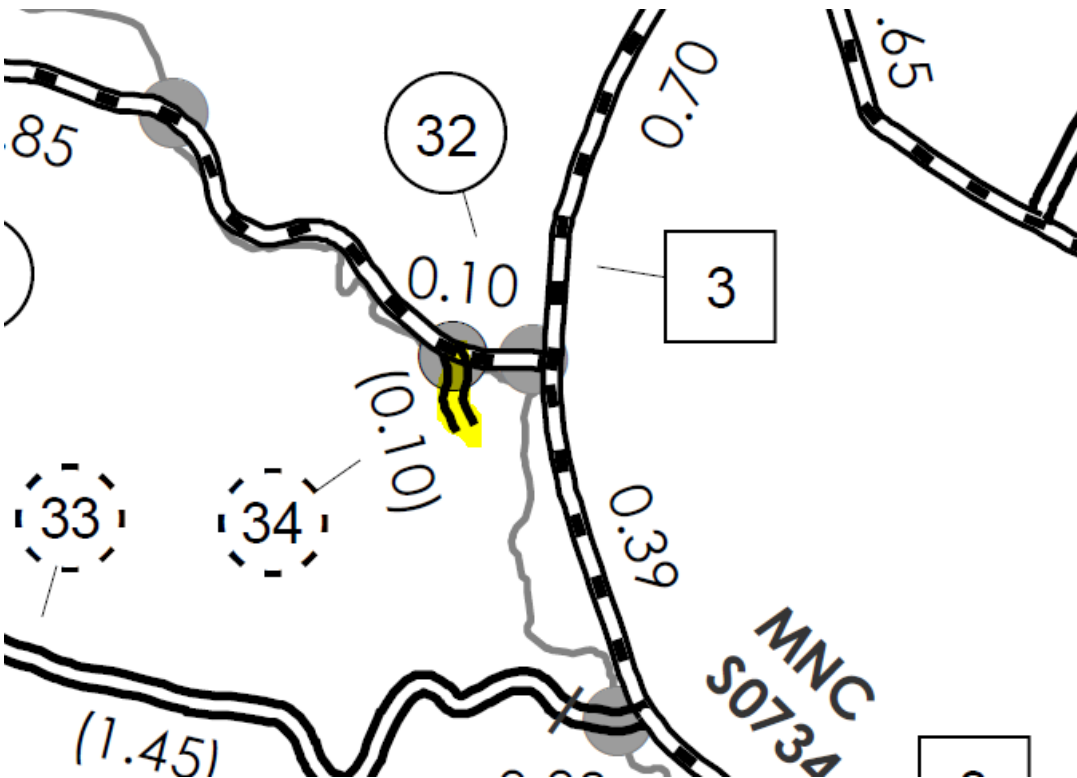

TOWN HWY. No.	LENGTH IN MILES	
	CLASS 3	CLASS 4
6	3.34	
7	1.40	
8	0.26	
10	0.19	
11	0.07	
12		(0.28)
14		(1.05)
16	1.00	
17	0.35	
18	0.63	
19	0.80	
20	1.60	
21	1.92	
22	0.20	
23	0.85	
24	0.55	(0.47)
25	0.13	
27	0.79	
28	1.55	
29	0.60	
30	0.08	
31	0.13	
32	1.22	
33	0.08	(1.45)
34		(0.10)
35	2.10	
36	0.50	

3. Also, if a road is reclassified, VTrans would need documentation in addition to the Selectboard meeting minutes. We need evidence of a site visit and notice of such site visit and notice of the public meeting/hearing of the reclassification discussion and decision. We also need documentation that abutting landowners have been specifically notified.
4. The mileage entered in the "Added" column for the Class 2 category is incorrect. I have corrected it in the attached document and would need the Selectboard notified. The 0.02 miles is actually added to the Legal Trail (LT-6), not US-2. US-2 is reduced by 0.012 miles, but there is no addition. I have also entered 0.02 miles in the Legal Trail/Added cell of the form to reflect the new miles of LT-6. I have adjusted the totals as well. I attached a map to help explain the changes better.

Please feel free to call me if you have any questions,

Thank you!

Pam

**Pamela DeAndrea (she/her)** | AOT GIS Professional III  
 Policy, Planning & Research Bureau – Mapping Section  
 Policy, Planning & Intermodal Development Division  
 Vermont Agency of Transportation  
 219 North Main Street | Barre, VT 05641  
[802-793-7555 phone](tel:802-793-7555) | [pam.deandrea@vermont.gov](mailto:pam.deandrea@vermont.gov)  
<http://vtrans.vermont.gov>

**From:** [DeAndrea, Pam](#)  
**To:** [tc@cabotvt.us](mailto:tc@cabotvt.us)  
**Subject:** Road Mileage changes for Cabot 2023  
**Date:** Tuesday, January 3, 2023 12:52:00 PM

---

Good afternoon Betty,

You will soon be receiving an updated Mileage Certificate for 2023 from the Vermont Agency of Transportation. Due to the relocation of Bridge 88 along Route 2 in Cabot, we have updated the road data resulting in the following mileage updates for Cabot:

US-2: -0.12 miles (US Highway total from 6.210 to 6.09 miles)

LT-6: + 0.02 miles (LT-6 miles from 0.90 to 0.92 miles)

We will include these changes on the 2023 Mileage Certificate and provide a new Town Highway map to the Town this year.

Best,

Pam

**Pamela DeAndrea (she/her)** | AOT GIS Professional III, Mapping Section  
Vermont Agency of Transportation  
219 North Main Street | Barre, VT 05641  
802-793-7555 | [pam.deandrea@vermont.gov](mailto:pam.deandrea@vermont.gov)

