District 7
Certcode 0905-0

CERTIFICATE OF HIGHWAY MILEAGE YEAR ENDING FEBRUARY 10, 2021

Fill out form, make and file a copy with the Town Clerk, and submit the Mileage Certificate on or before February 20, 2021 to: Vermont Agency of Transportation, Division of Policy, Planning and Intermodal Development, Mapping Section through upload to the secure FTP site or if necessary via mail to: VTrans PPAID - Mapping Section, 2178 Airport Rd, Unit B, Berlin, VT 05641.

We, the members of the legislative body of CORINTH

in ORANGE

County


on an oath state that the mileage of highways, according to Vermont Statutes Annotated, Title 19, Section 305, added 1985, is as follows:

| Town Highways | Previous Mileage | Added Mileage | Subtracted Mileage | Total | Scenic Highways |
|---------------------------------------------------------|---------------------------------------------------------------------------------------------------------------|-------------------------------------------------------------------------|------------------------------------------------------------------------------------------|----------------------------|------------------------------------|
| Class 1 | 0.000 | | | | 0.000 |
| Class 2 | 21.750 | | | | 0.000 |
| Class 3 | 48.69 | | 0.04 | 48.65 | 0.000 |
| State Highway | 3.963 | | | | 0.000 |
| Total | 74.403 | | | 74.363 | 0.000 Mileage totals calculated by |
| * Class 1 Lane | 0.000 | | | | K.Alley (VTrans) |
| * Class 4 | 23.49 | Free Augustus | | | 0.000 |
| * Legal Trail | 8.17 | | | | |
| EW HIGHWAYS: | ON AND DESCRIA Please attach Selectn Please attach SIGNE | nen's "Certificat | e of Completion and | l Opening". | 2 |
| SCONTINUED: 1 | Please attach Selectn Please attach SIGNE | nen's "Certificate D copy of proceed | e of Completion and dings (minutes of m | l Opening". eeting). | meeting). |
| SCONTINUED: F | Please attach Selectn Please attach SIGNE | nen's "Certificate D copy of proceed e attach SIGNEL with TH-3 (Chelses | dings (minutes of moderates) copy of proceedings (minutes) | eeting). | |
| SCONTINUED: POR CLASSIFIED/RED IN CL3 TH-57 (Abe James) | Please attach Selection Please attach SIGNE MEASURED: Please acobs Rd) intersection | nen's "Certificate D copy of proceed e attach SIGNEL with TH-3 (Chelses | dings (minutes of moderating) copy of proceeding a Rd) reconfigured mating/discontinuing | eeting). gs (minutes of i | |
| SCONTINUED: POR CLASSIFIED/RED IN CL3 TH-57 (Abe James) | Please attach Selection Please attach SIGNE MEASURED: Please acobs Rd) intersection S: Please attach a co | nen's "Certificate D copy of proceed e attach SIGNEL with TH-3 (Chelses | dings (minutes of moderating) copy of proceeding a Rd) reconfigured mating/discontinuing | eeting). gs (minutes of i | ways. |

AGENCY OF TRANSPORTATION APPROVAL: Signed copy will be returned to T/C/V Clerk.

APPROVED:

DATE:

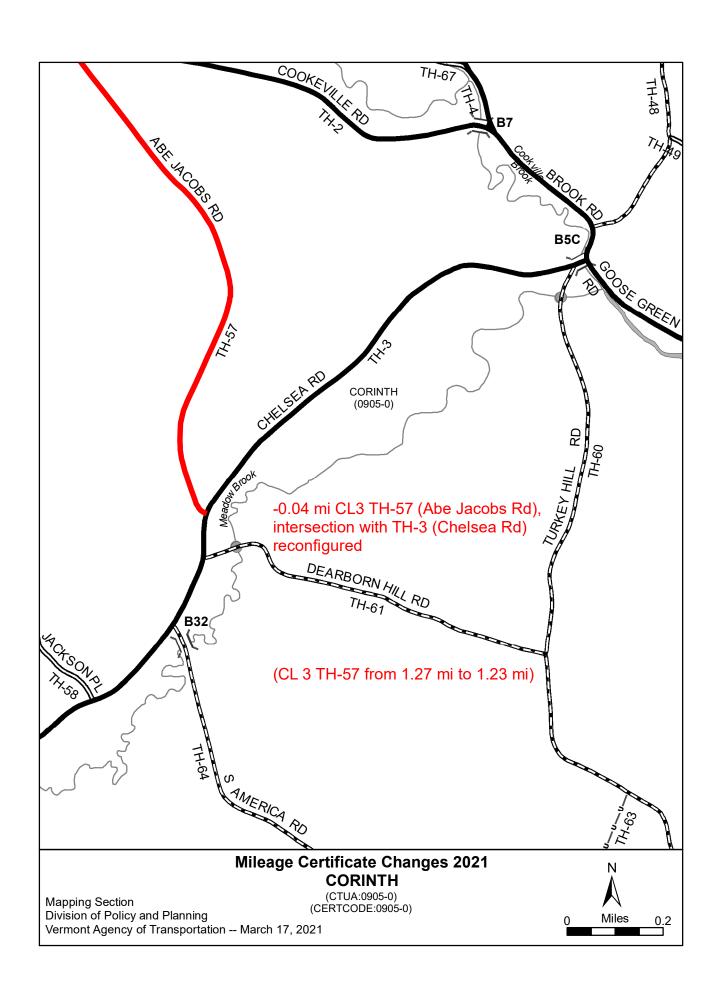

Moulton, Sara

From: AOT - Mileage Certificates

Sent: Tuesday, February 16, 2021 8:30 AMTo: Lee Porter; AOT - Mileage CertificatesSubject: RE: Where to send the completed form

Would you be able to attach it as an email? If so, the preferred address to send it to would be aot.mileagecertificates@vermont.gov, but it would also be fine to email it to me directly. If that doesn't work, the backup option is the mail it via USPS to the Berlin, VT address.

Please let me know if you need further assistance.

Sara Moulton, GISP | AOT GIS Professional III Vermont Agency of Transportation 219 North Main Street | Barre, VT 05641 - Physical Address 2178 Airport Rd, Unit B | Berlin, VT 05641 - Mailing Address sara.moulton@vermont.gov http://vtrans.vermont.gov/planning/maps AOT.MileageCertificates@vermont.gov

From: Lee Porter <corinthroadcomm@gmail.com>

Sent: Tuesday, February 16, 2021 8:23 AM

To: AOT - Mileage Certificates <AOT.MileageCertificates@vermont.gov>

Subject: Where to send the completed form

EXTERNAL SENDER: Do not open attachments or click on links unless you recognize and trust the sender.

Sara or Kelly,

Thank You

I have the certificate of Highway Mileage completed for the Town of Corinth. However I do not find any type of address to send it via e-mail.

On the form I do see where it says to send it to: Vermont Agency of Transportation, Division of Policy, Planning and Intermodal Development, Mapping Section through upload to the secure FTP site.

I am sorry but I do not see any user friendly way of sending anything. Can either of you give me directions?

| Corinth, | mmissioner | | |
|----------|---------------------------|--|--|
| | Virus-free. www.avast.com | | |

Alley, Kerry

From: Alley, Kerry

Sent: Thursday, December 10, 2020 6:37 PM

To: corinth@tops-tele.com

Cc: Moulton, Sara

Subject:Town Highway Map updateAttachments:Corinth_Change_2021.pdf

Categories: Z_CertYear_2021

Attached:Corinth Change 2021.pdf

Good afternoon Joe and the Corinth Selectboard,

The person answering the phone in the Town Office recommend that I direct this correspondence to Joe, but it is also important that the Selectboard be aware of this as it is relevant to the upcoming 2021 Mileage Certificate.

A coworker of mine noticed that Abe Jacobs Rd (class 3 TH-57) has a new alignment intersecting with Chelsea Rd (class 2 TH-3). In order to update the Town Highway Map, The VTrans Mapping Section needs this change documented on the 2021 Mileage Certificate that will be issued to Towns in January. Because the realignment is within the existing TH-57 right of way, we will process it as a remeasurement, and want to confirm with the Town of Corinth that we have correctly mapped and determined the new mileage of TH-57 (as detailed below and on the attached map). No additional documentation is required, and we will pre-load the remeasurement onto the 2021 Mileage Certificate unless there is additional information that you feel we should take into account.

It is our procedure to ensure that the new total mileage represents the entire highway as accurately as possible, which avoids complications due to possible errors in past measurements. Based on our GIS data, the new map length of TH-57 is 1.23 mi (when rounded to the nearest 100th of a mile). In order for us to update our records to this new mileage, we need to subtract 0.04 mi from TH-57. Please refer to the attached map for details regarding the map lengths and official class 3 mileages associated with TH-57 before and after this remeasurement.


Unless we are given additional information that should be take into account, you will find the following change preloaded on Corinth's 2021 Mileage Certificate:

-0.04 mi CL3 TH-57 (Abe Jacobs Rd) remeasured after intersection realignment.

Please feel free to reach out to me with any questions you might have regarding this change or the Town Highway Map in general.

Kerry Alley Mileage Certificate Specialist VTrans Mapping Section

Kerry Alley | GIS Professional III Vermont Agency of Transportation 219 North Main Street | Barre, VT 05641 - Physical Address 2178 Airport Rd, Unit B | Berlin, VT 05641 - Mailing Address

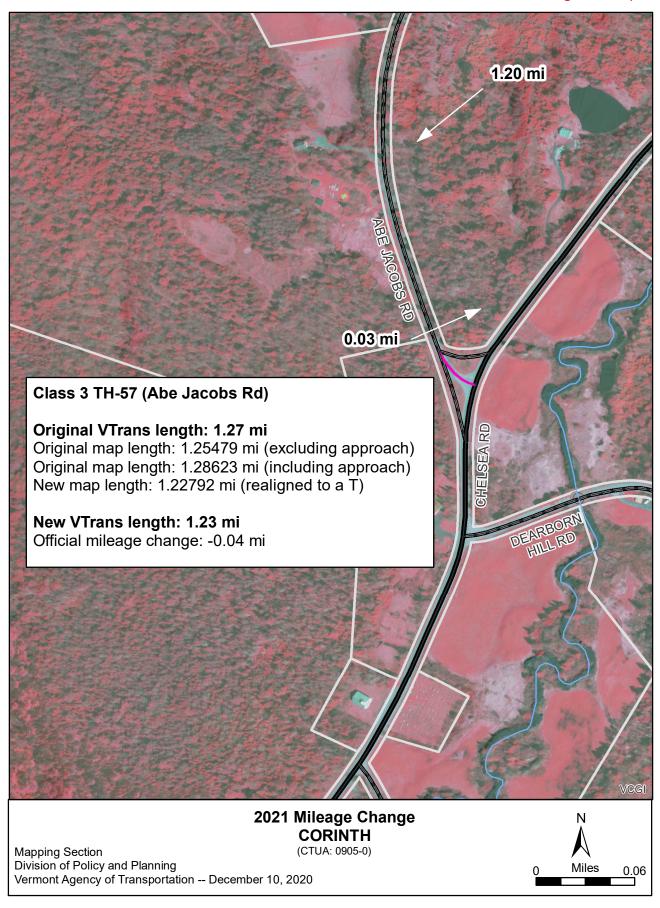

ROAD INVENTORY FORM

VERMONT AGENCY OF TRANSPORTATION PROJECT PLANNING DIVISION MAPPING AND ROAD INVENTORY SECTION

| PARTY CHIEF | <u> </u> | 1 | 00 | 0 (| Je | MAF | PING | AND ROAD IF | TOWN Corinth COUNTY Orange HWY. DIST. NO. 7 | | | |
|-----------------------------------|----------|------------|--------------------------------|-----|-------|-----------|------------|-------------|----------------------------------------------------|------------|-------|----------|
| TOWN OFFICIAL B. Magaon TITLE R-C | | | | | | | | | ROAD SYSTEM & NO. 7-57 SHEET NO. 4 OF DATE 8-26-86 | | | |
| TITLE | _ | | | | | | | | SHEET NO | OF DATE | 0-609 | <u> </u> |
| SURFACE TYPE & WIDTH | SHOULDER | & WIDTH | SIDEWALK TYPE R WIDTH | | TCHES | CONDITION | ROAD CLASS | REMARKS | | | | |
| | LT. | | | | ū | ŭ | , M | | | | | |
| | | | | | | | | | | | | |
| | | | | | | | | | | | | |
| | | | | | | | | | | | | - |
| | - | | | | | | | | | | | |
| | - | | | | | | | | | | | |
| - | | | | | | | | | | | | |
| | | | | | | | | | | | | |
| | | | | | | | | | | | | |
| | | | | | | | | | | | | - |
| | | | | | | | | | | | | |
| | | | | | | | | | 13 | 7 | | |
| | | | | | | | | | Ct 2#3/ | 24 CC | 2 #3 | 1.24 |
| | | | | | | | | | Ca | | | |
| | | | | | | | | | | 58 | 4 | |
| | _ | | | | | | | , | | | | |
| | | | | | | | | H | 0 | 76 | | |
| | | | | | | | | | | / = | ,, | |
| | | | | | | | | | 0 | 67 | H | |
| | - | | | | | | | . 1 | | <i>-</i> 0 | | |
| | - | | | | | | | + | 0 | 58 | | |
| | | | | | | | | | 0 | 50 | C 11 | |
| | | \vdash | | | | | | | U | 30 | 5.4. | |
| E-18 | | 2.1 | | | | | | | 0 | 00 | | |
| 0 | | | | | | | | | CLSAC | | | J |
| | | | | | | | | | | CLZ | #2 | |

Alley, Kerry

From: Croft, Johnathan

Sent: Monday, August 31, 2020 4:26 PM

To:Alley, Kerry; Moulton, SaraCc:Trunzo, Michael; Blouin, JamesSubject:Corinth - TH-57 realignment

Categories: Z_Preload, Z_CertYear_2021

Good afternoon Kerry and Sara,

It looks like there has been a realignment at the end of TH-57 in Corinth at the intersection of TH-3 to remove a "Y" and make it a "T". Please work with the Town to add this to the pending changes for 2021. This will affect a few arcs, nodes and node legs, and route log points.

500170250248 500170250245 500170250244



There is a chance that Michael has already identified this, but if not, please add this to pending list of changes for the next Mileage Certificates. Thanks,

Johnathan

Johnathan Croft | Mapping Section Chief Vermont Agency of Transportation 219 North Main Street | Barre, VT 05641 802-828-2600 | johnathan.croft@vermont.gov

